
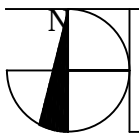


727 East Bethany Home Road

Phoenix . Arizona

Suite D224 - 1,425 SF

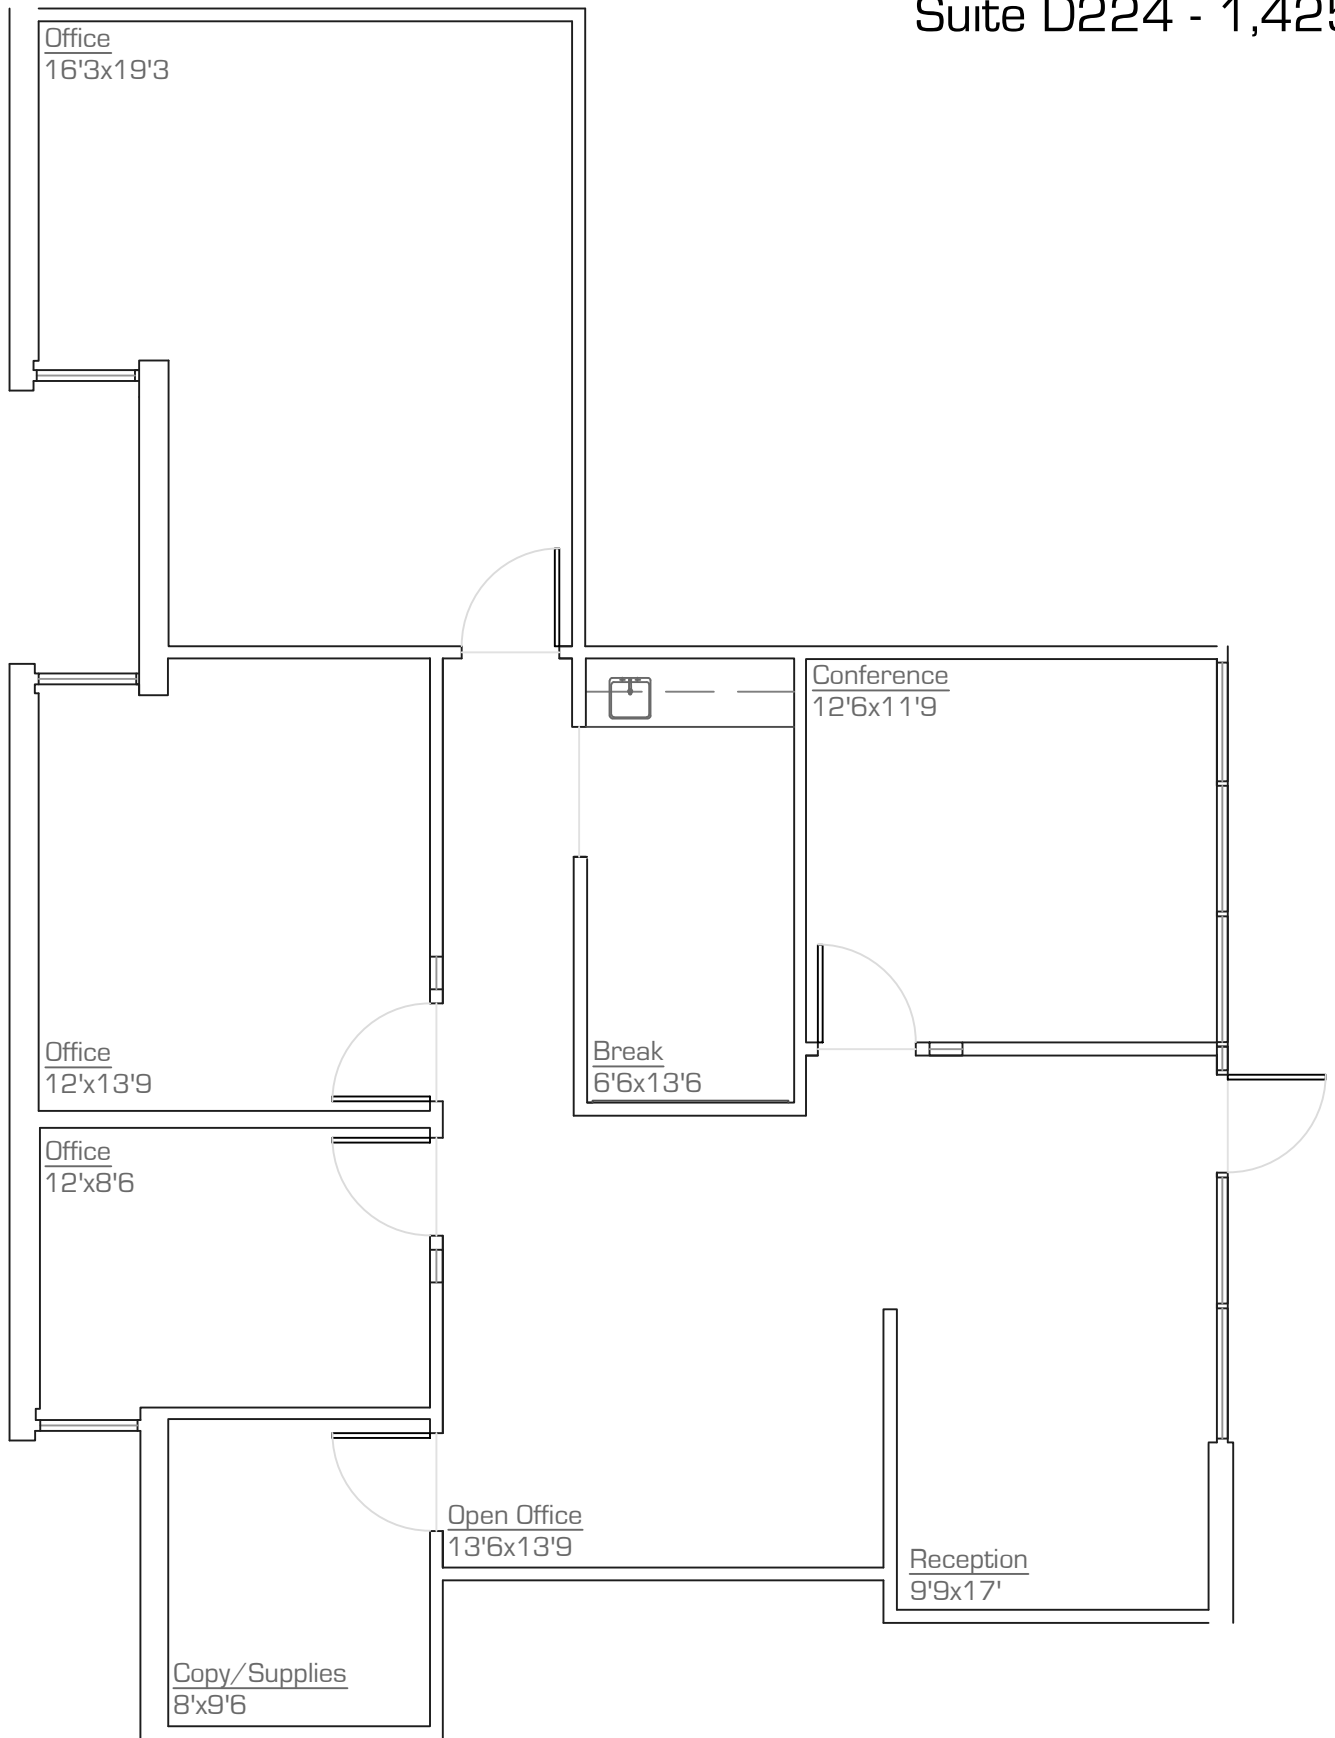

As-Built

scale: nts

22.September.2021

*All dimensions are approximate at ± 3"

*All information is of general nature

precisionDIMENSIONS

as-built & design

602.790.6412

